

EMPLOYER :



THE UNITED NATIONS
CHILDREN'S FUND
(UNICEF)

ENGINEER



GITEC CONSULT GMBH
IN ASSOCIATION WITH
CONSULTING ENGINEERING CENTER (CEC)

CONTRACTOR :




MID CONTRACTING Co.

CONSTRUCTION OF PHASE II WATER AND WASTEWATER NETWORKS AT ZAATARI REFUGEE CAMP

Electrical AS BUILT DRAWING
WATER PUMP STATION-7

October 2018

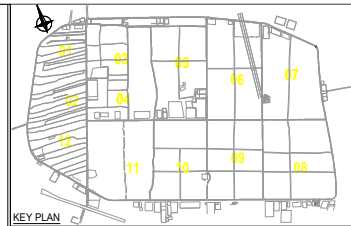

NOTE: Package no. 1 Serial No. For Drawing

District no.	Trades
1	Trades
2	Electrical
3	Plumbing
4	Sanitary & Ventilation
5	Structural
6	Painting
7	Excavation
8	Foundation
9	Roofing
10	Interior
11	Exterior
12	Other
13	Water Pump Station-1
14	Water Pump Station-2
15	Water Pump Station-3
16	Water Pump Station-4
17	Other

DRAWING #	DESCRIPTION
COVER PAGE	
4-07-09-000	INDEX (LIST OF DRAWING)
4-07-09-001	PUMPING STATION IN DISTRICT 7 SITE PLAN LIGHTING AND POWER CABLES
4-07-09-002	PUMPING STATION IN DISTRICT 7 VIEW 1
4-07-09-003	PUMPING STATION IN DISTRICT 7 LIGHTING
4-07-09-004	PUMPING STATION IN DISTRICT 7 SOCKET
4-07-09-005	PUMPING STATION IN DISTRICT 7 DISTRIBUTION BOARD
4-07-09-006	PUMPING STATION IN DISTRICT 7 MDB

Drawing No.	Drawing Title

REV.	DATE	DESCRIPTION
02	22/10/2018	AS BUILT DRAWING
01	16/10/2018	AS BUILT DRAWING
00	24/9/2018	AS BUILT DRAWING

PROJECT: CONSTRUCTION OF PHASE II WATER AND WASTEWATER NETWORKS AT ZAATARI REFUGEE CAMP

EMPLOYER: THE UNITED NATIONS CHILDREN'S FUND (UNICEF)

ENGINEER: GITEC CONSULT GMBH IN ASSOCIATION WITH CONSULTING ENGINEERING CENTER (CEC)


CONTRACTOR: MID CONTRACTING Co. AMMAN-JORDAN

DRAWING TITLE

LIST OF DRAWING

DATE	DESCRIPTION	APPROVED BY	REVISION

SCALE	DATE	SHEET
2	N.T.S	22/10/2018 1/1

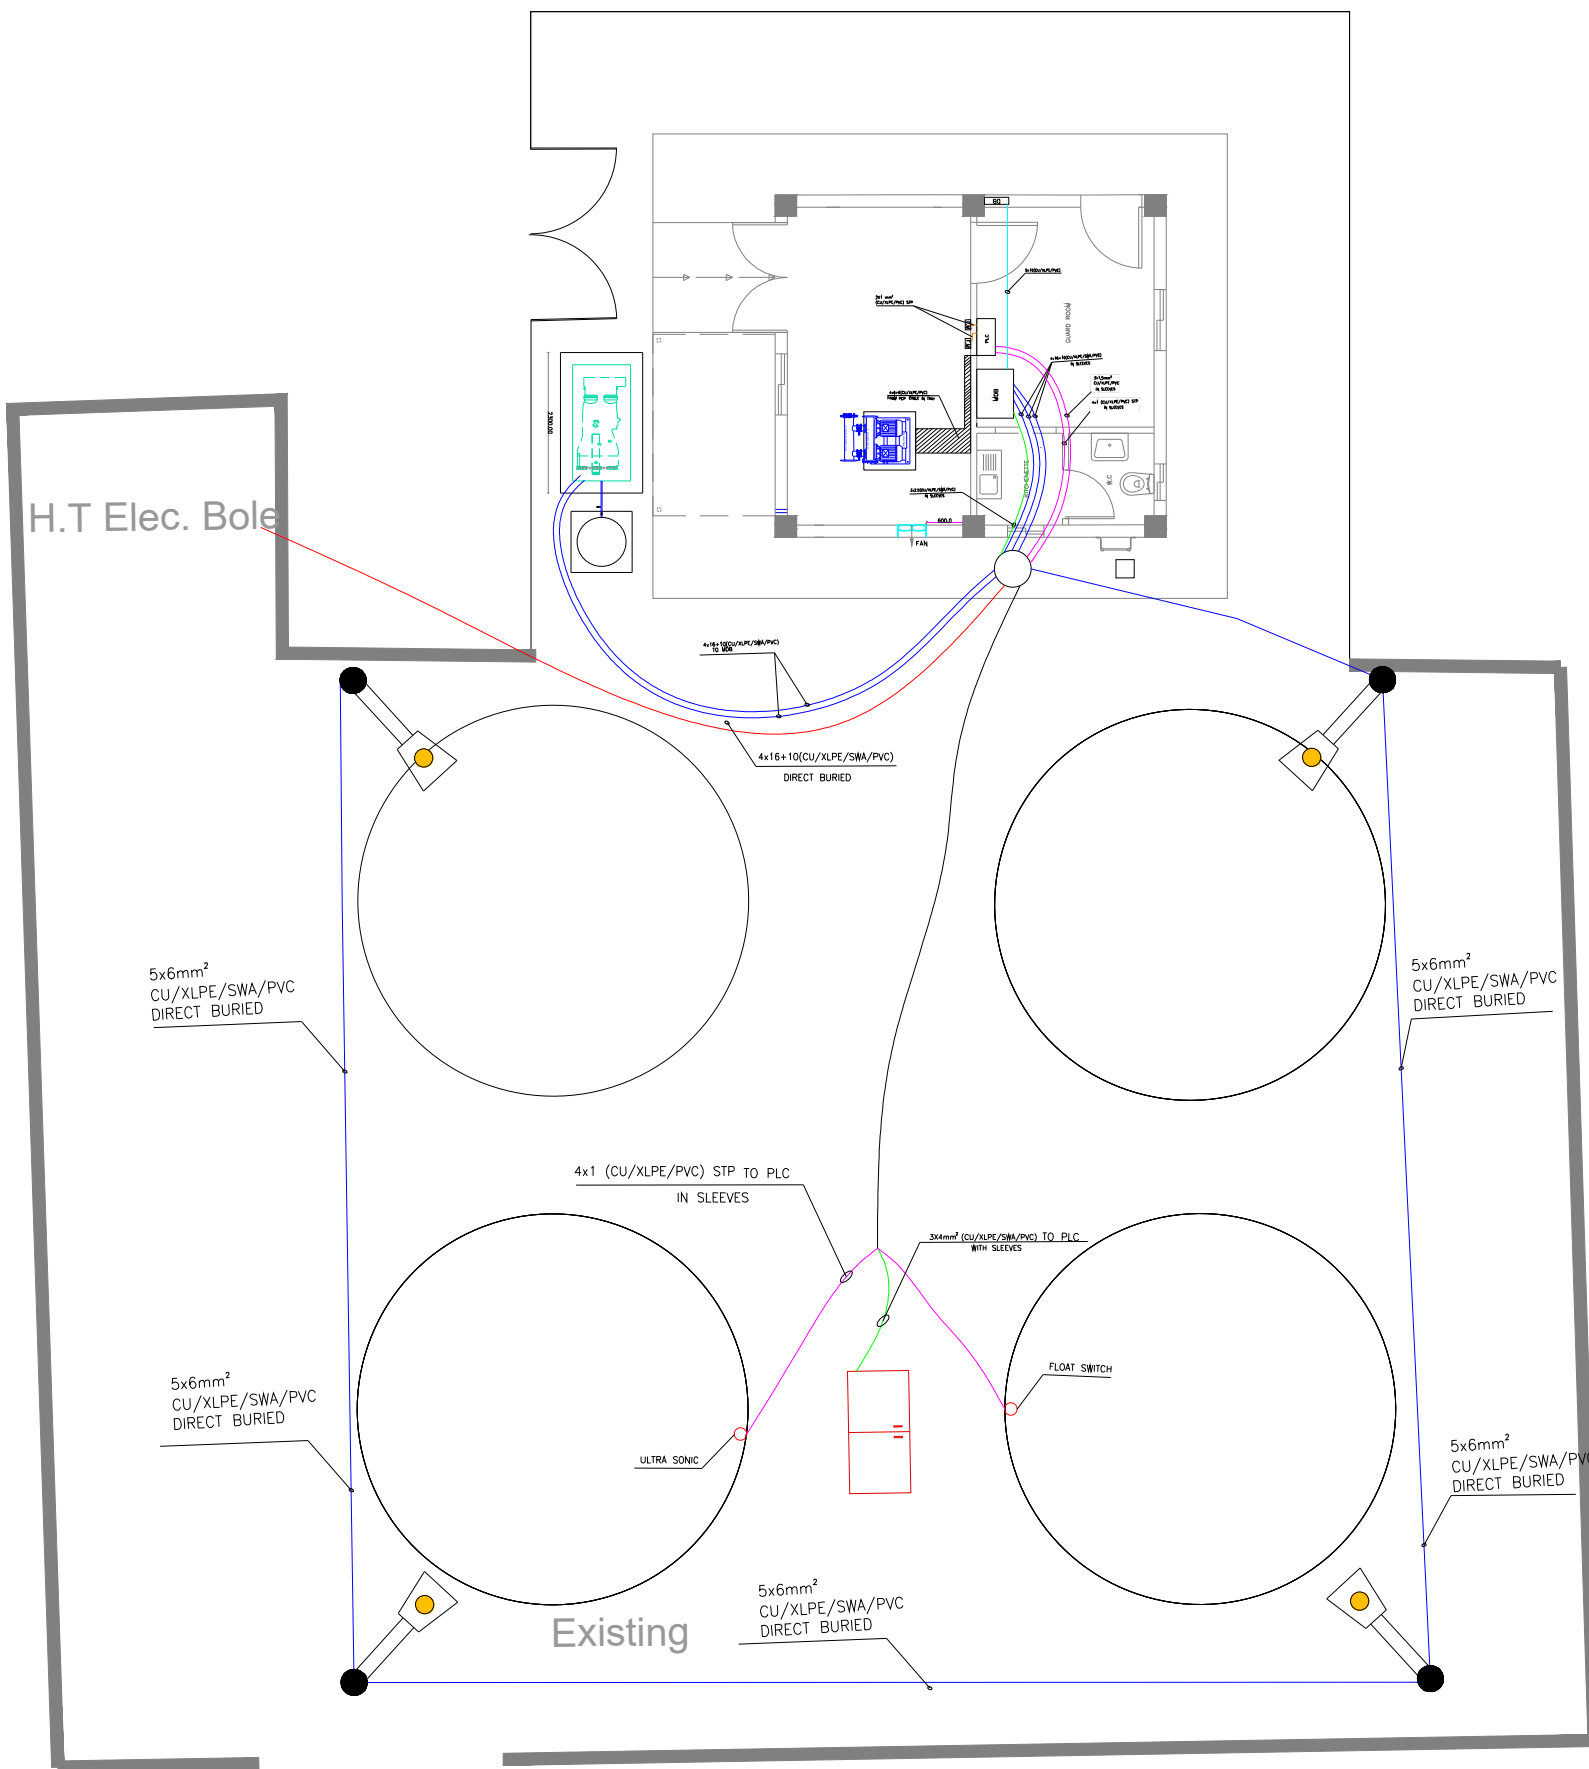

NOTE:

Package no.	District no.	Serial No. For Drawing	Trades
1	1	1	Mechanical
1	2	2	Electrical
1	3	3	Plumbing
1	4	4	Structural
1	5	5	Masonry & Cladding
1	6	6	Painting
1	7	7	Site Work
1	8	8	Landscaping
1	9	9	Other
1	10	10	Mechanical
1	11	11	Electrical
1	12	12	Plumbing
1	13	13	Structural
1	14	14	Masonry & Cladding
1	15	15	Painting
1	16	16	Site Work
1	17	17	Landscaping
1	18	18	Other

LEGEND:


Symbol	Description
(Empty)	(Empty)
(Empty)	(Empty)
(Empty)	(Empty)
(Empty)	(Empty)

REFERENCE DRAWINGS

Drawing No.	Drawing Title

REV.	DATE	DESCRIPTION
02	22/10/2018	AS BUILT DRAWING
01	16/10/2018	AS BUILT DRAWING
00	24/9/2018	AS BUILT DRAWING

PROJECT: CONSTRUCTION OF PHASE II WATER AND WASTEWATER NETWORKS AT ZAATARI REFUGEE CAMP


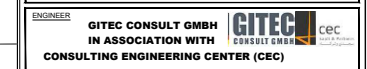


DRAWING TITLE: PUMPING STATION IN DISTRICT 7 SITE PLAN LIGHTING AND POWER CABLES

NO.	DATE	BY	CHECKED BY	DATE	SCALE	DATE	SHEET

4-07-9-01 02

2 N.T.S 22/10/2018 1/1

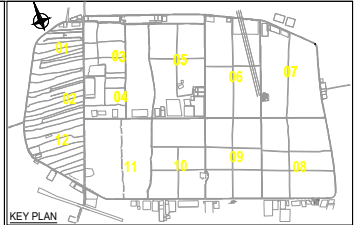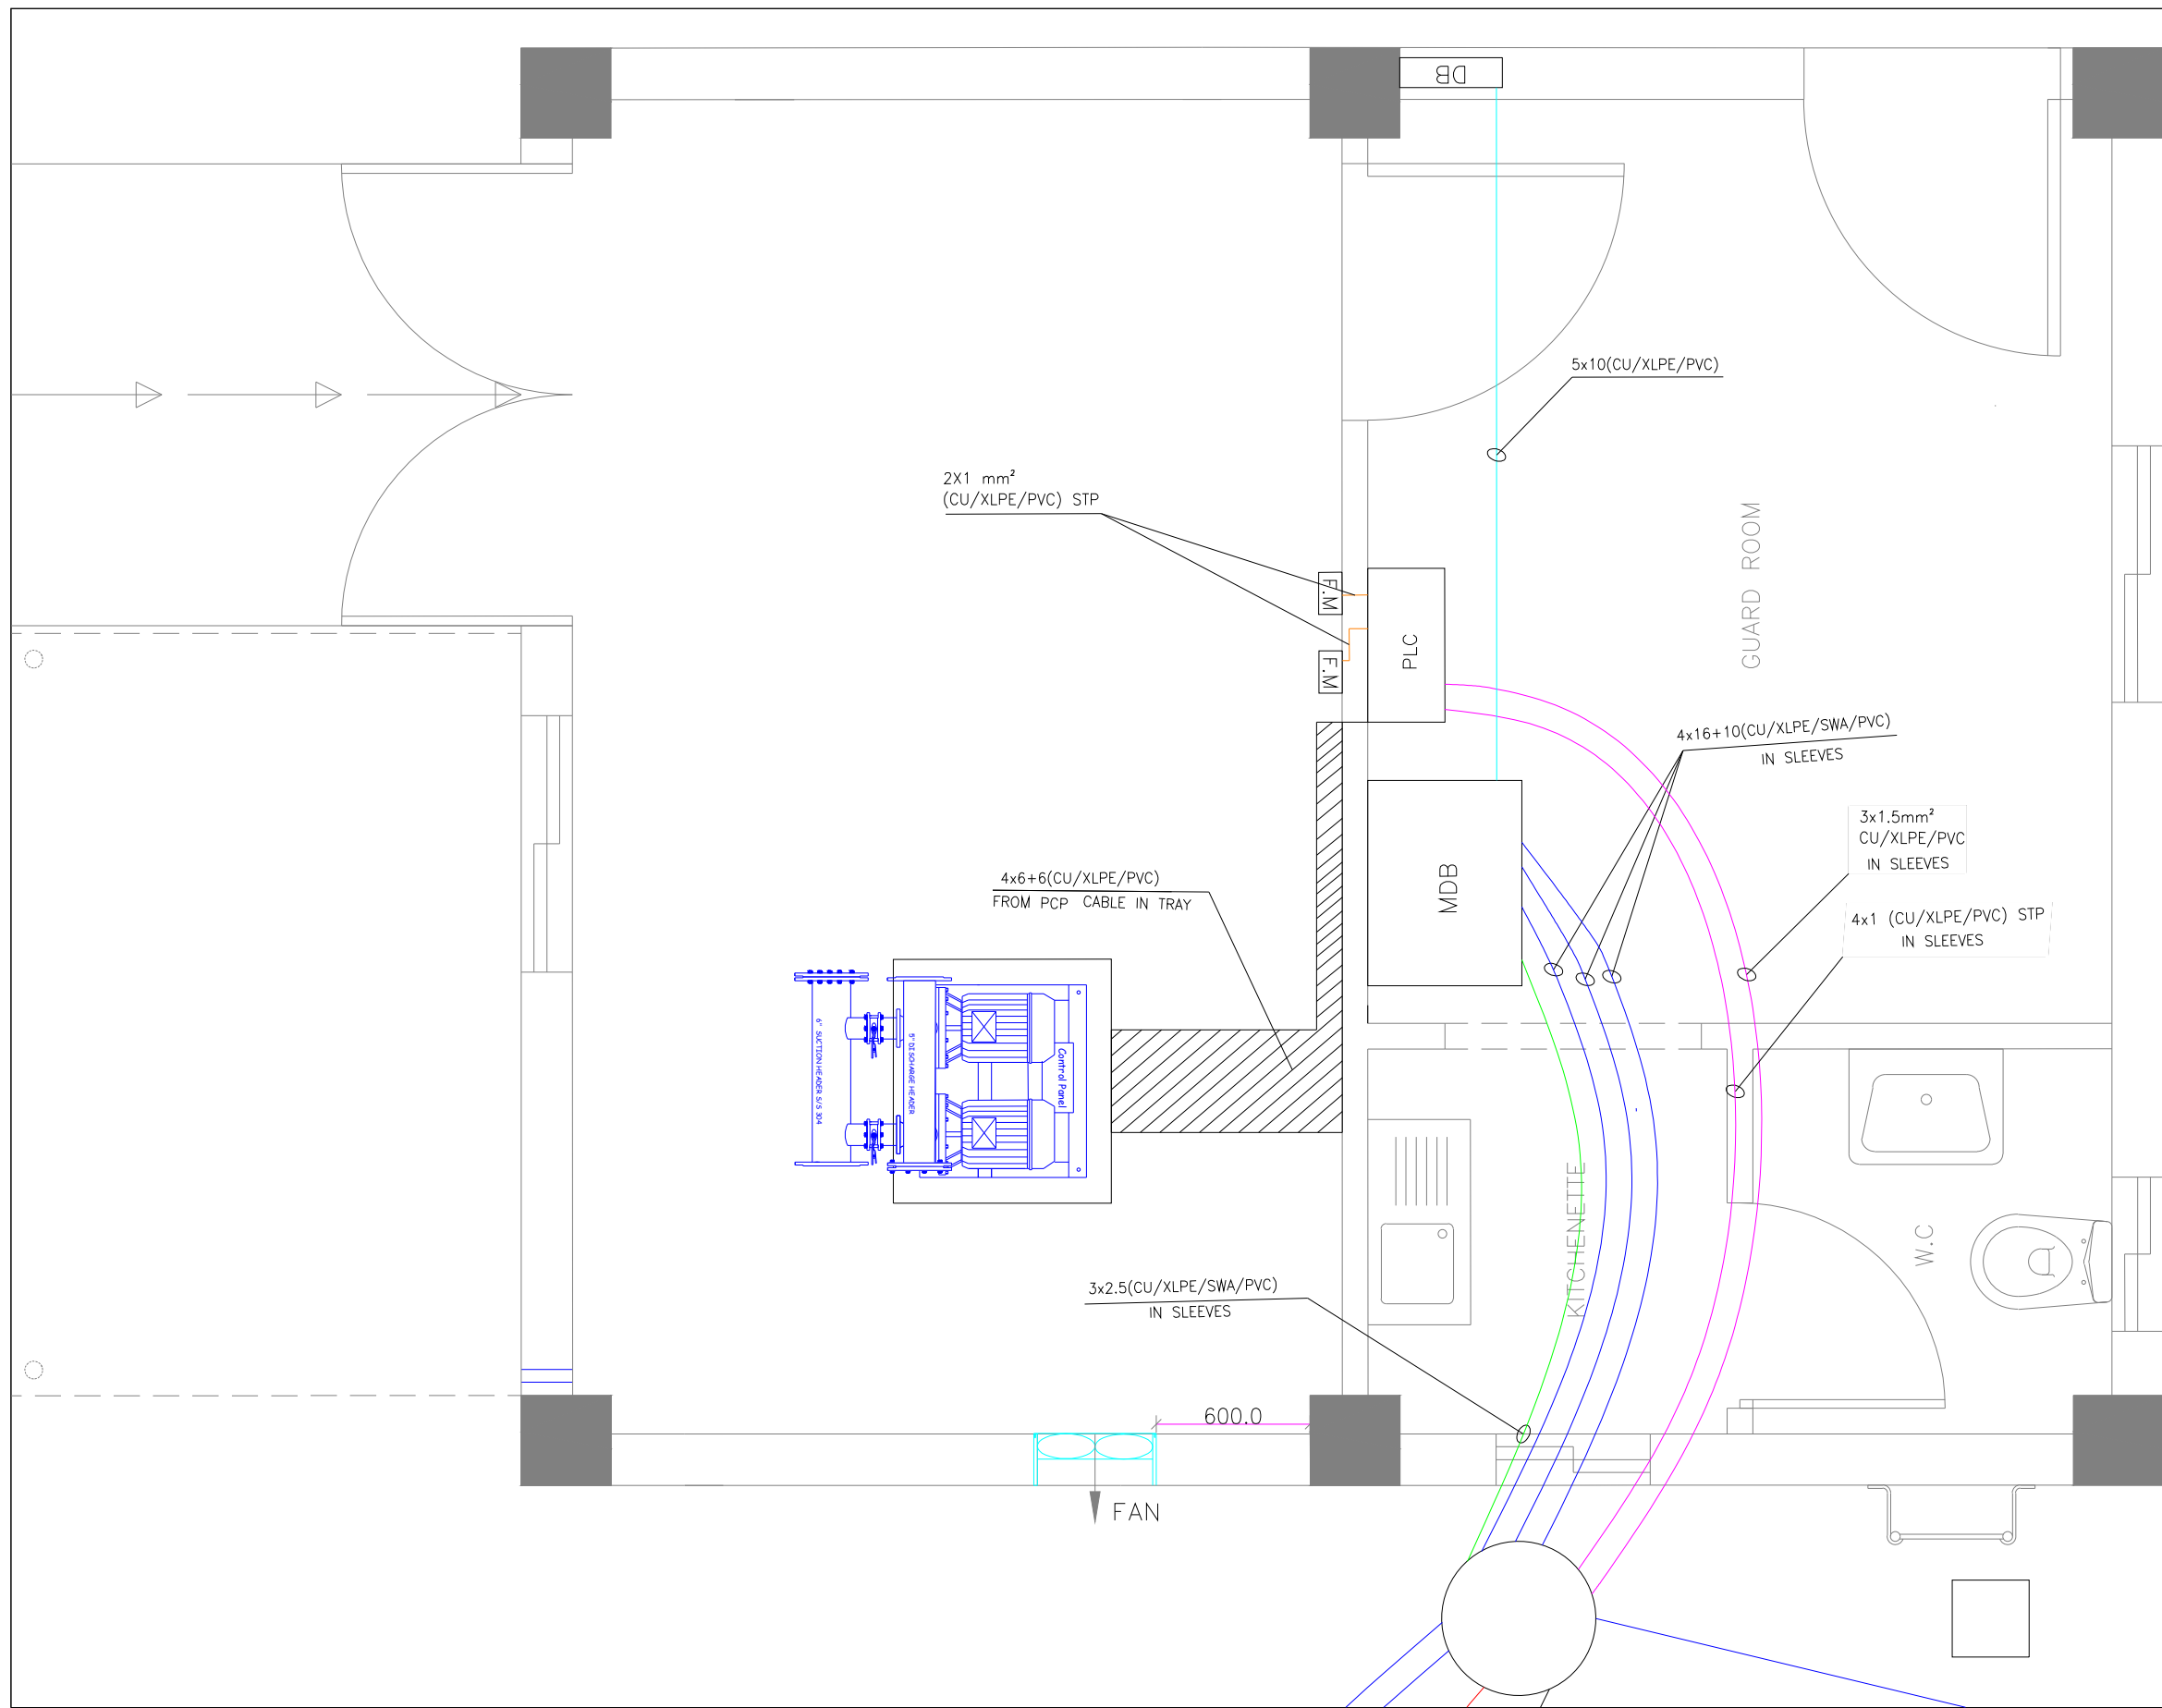

NOTE:

Package no.	District no.	Serial No. For Drawing	Trades
1	1	1	1
1	2	2	2
1	3	3	3
1	4	4	4
1	5	5	5
1	6	6	6
1	7	7	7
1	8	8	8
1	9	9	9
1	10	10	10
1	11	11	11
1	12	12	12

LEGEND:

Symbol	Description

REFERENCE DRAWINGS

Drawing No.	Drawing Title

REV.	DATE	DESCRIPTION
02	22/10/2018	AS BUILT DRAWING
01	16/10/2018	AS BUILT DRAWING
00	24/9/2018	AS BUILT DRAWING

PROJECT: CONSTRUCTION OF PHASE II WATER AND WASTEWATER NETWORKS AT ZAATARI REFUGEE CAMP


EMPLOYER: THE UNITED NATIONS CHILDREN'S FUND (UNICEF)

ENGINEER: GITEC CONSULT GMBH IN ASSOCIATION WITH CONSULTING ENGINEERING CENTER (CEC)


CONTRACTOR: MID CONTRACTING Co. AMMAN, JORDAN

DRAWING TITLE: PUMPING STATION IN DISTRICT 7 VIEW 1

NO.	DATE	SCALE	DATE	NO.
2		N.T.S	22/10/2018	1/1

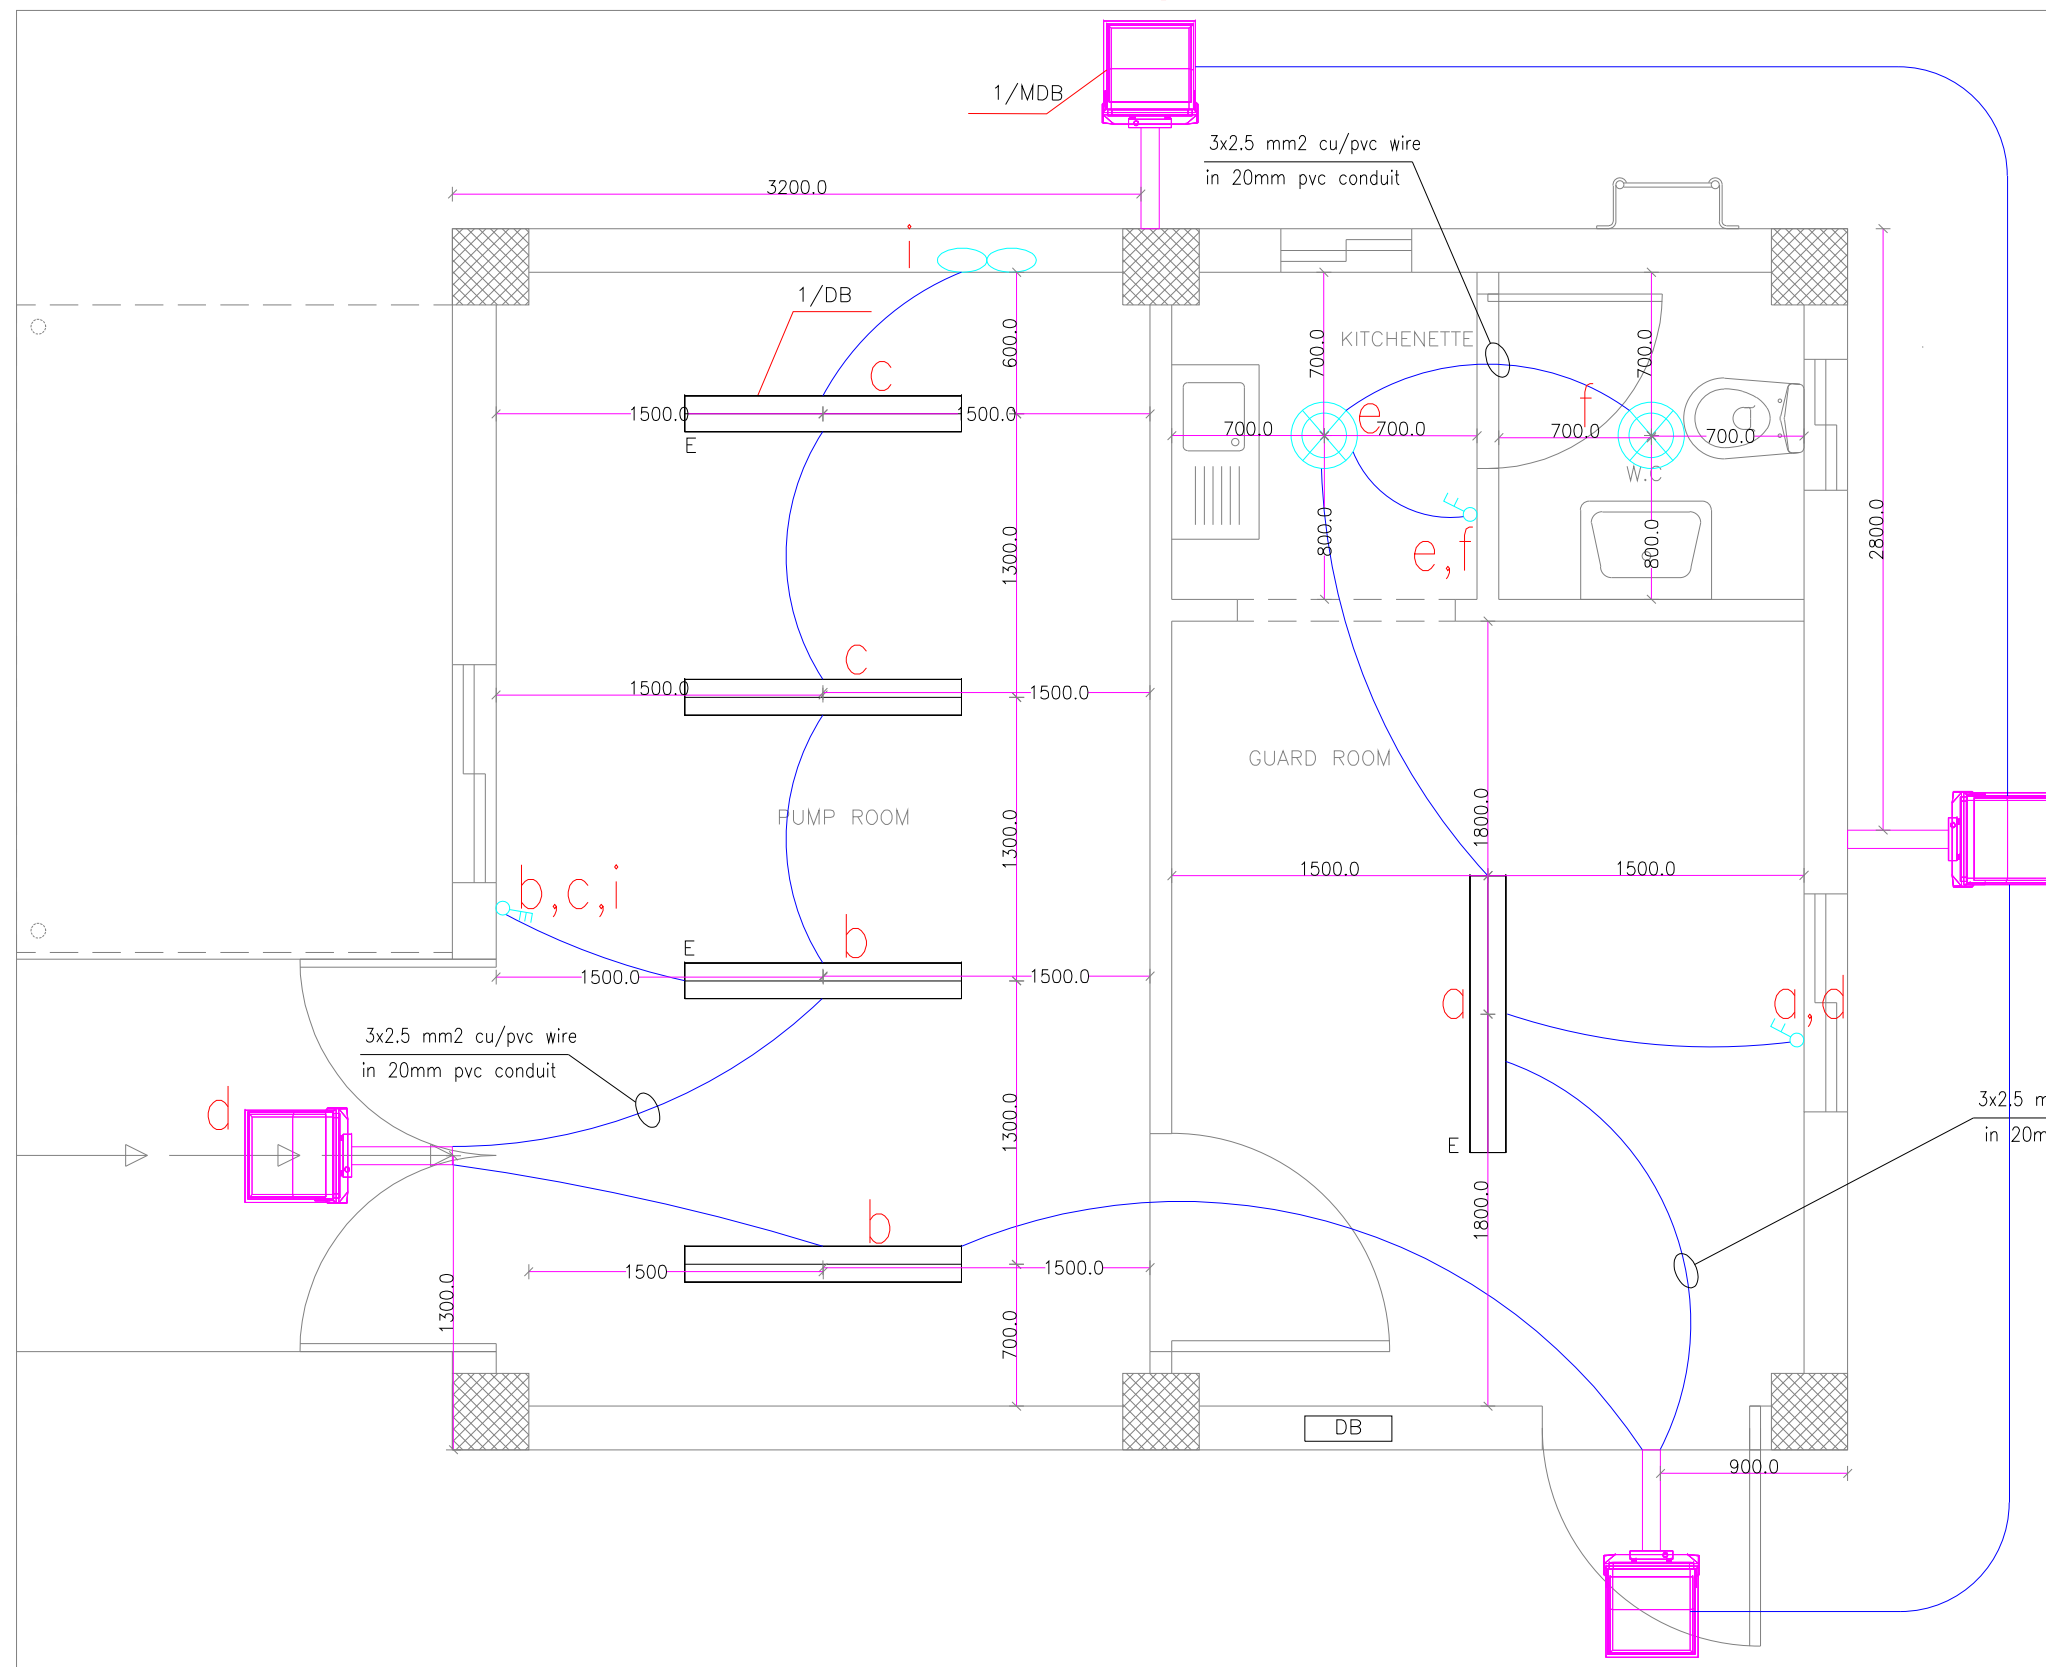

GROUND PLAN

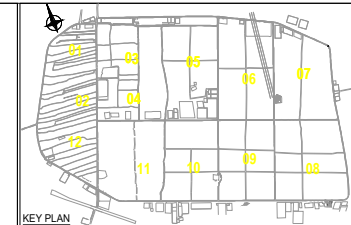

NOTE:

Package no.	District no.	Trades	Serial No. For Drawing
1	7	1	01
2	7	2	02
3	7	3	03
4	7	4	04
5	7	5	05
6	7	6	06
7	7	7	07
8	7	8	08
9	7	9	09
10	7	10	10
11	7	11	11
12	7	12	12

LEGEND:

- 2x36watt Fluorescent light fixture, with prismatic diffuser, electronic ballast, IP65.
- 1x70W HPS, IP54.
- 1x20W Compact Fluorescent, IP44.
- fin.

2- ALL SOCKETS AND SWITCHES
135cm F.F.L HEIGHT

REFERENCE DRAWINGS

Drawing No.	Drawing Title

REV.	DATE	DESCRIPTION
02	22/10/2018	AS BUILT DRAWING
01	16/10/2018	AS BUILT DRAWING
00	24/9/2018	AS BUILT DRAWING

PROJECT: CONSTRUCTION OF PHASE II WATER AND WASTEWATER NETWORKS AT ZAATARI REFUGEE CAMP


EMPLOYER: THE UNITED NATIONS CHILDREN'S FUND (UNICEF)

ENGINEER: GITEC CONSULT GMBH IN ASSOCIATION WITH CONSULTING ENGINEERING CENTER (CEC)

CONTRACTOR: MID CONTRACTING Co. AMMAN, JORDAN

DRAWING TITLE: PUMPING STATION IN DISTRICT 7 LIGHTING

NO.	DATE	SCALE	DATE	NO.
2	N.T.S	22/10/2018	1/1	02

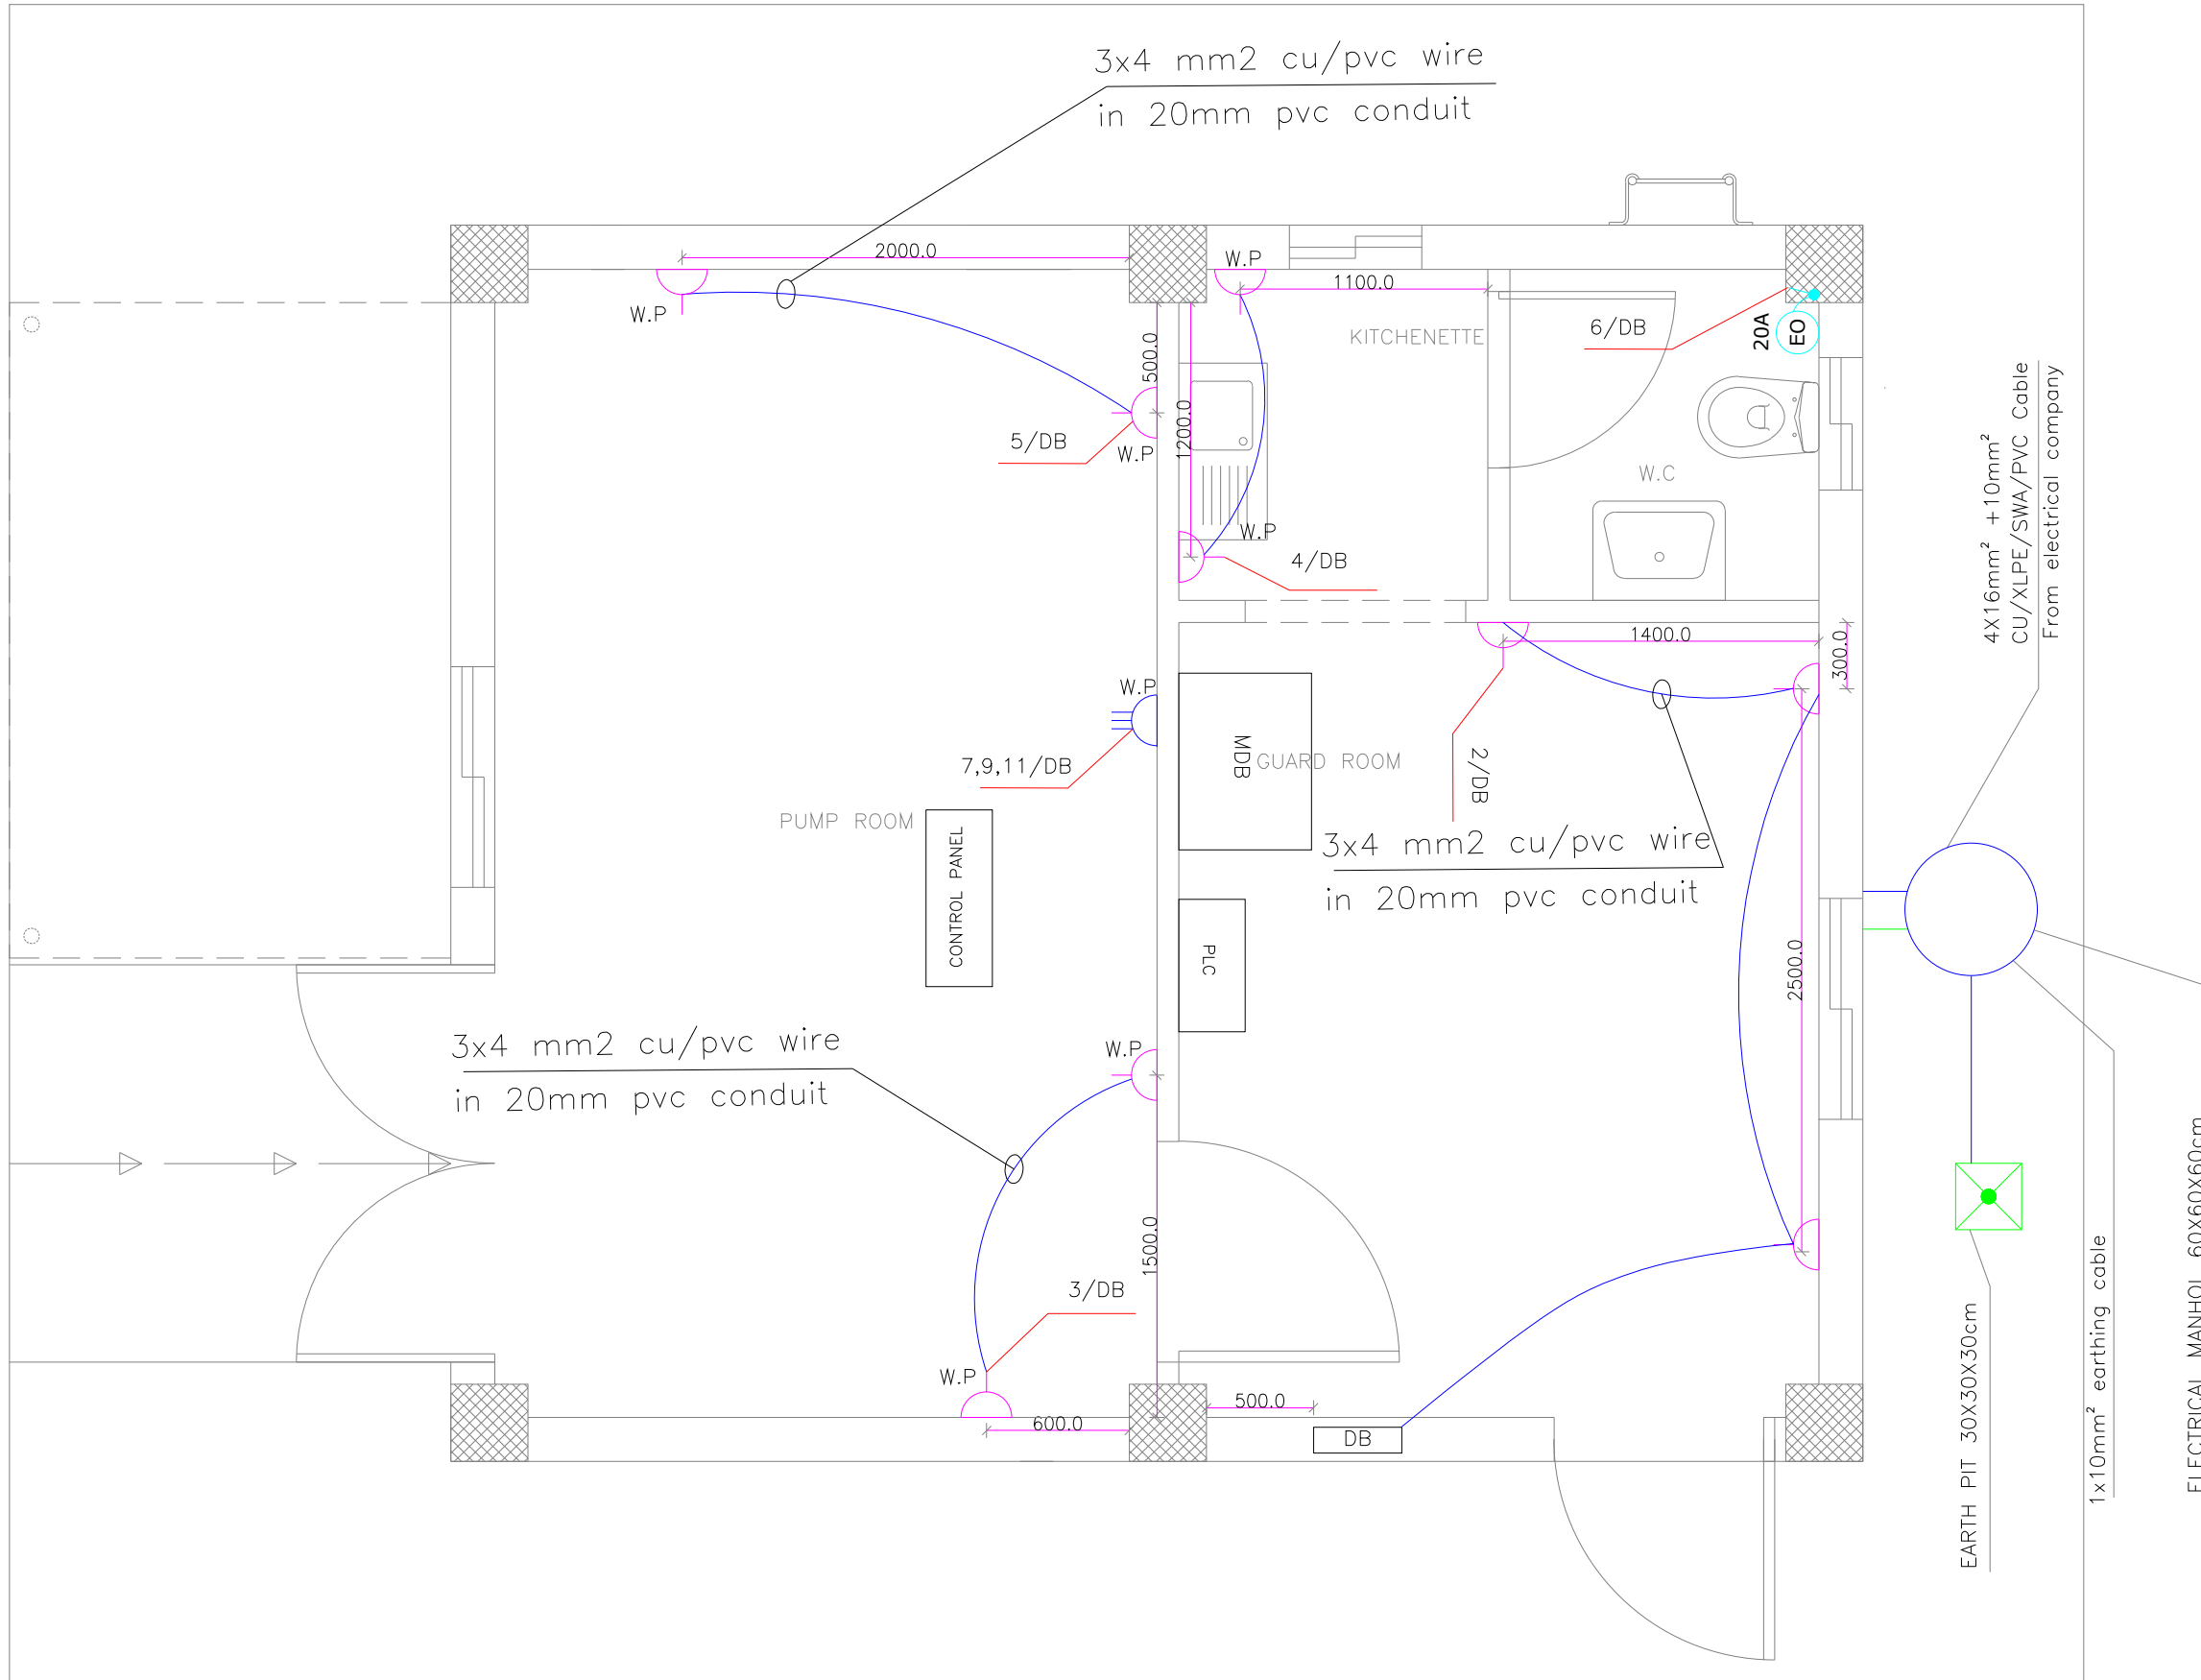

GROUND PLAN



NOTE:

Package no.	District no.	Serial No. For Drawing
1	1	1
2	2	2
3	3	3
100	100	100

- LEGEND:
- 13A single socket.
 - 13A water proof single socket.
 - 3-ph, 16A water proof socket.
 - 20A double pole heater.
 - Distribution board.
 - Main distribution board.
 - Programmable logic controller.
- 2- ALL SOCKETS AND SWITCHES
135cm F.F.L HEIGHT

REFERENCE DRAWINGS

Drawing No.	Drawing Title

REV.	DATE	DESCRIPTION
02	22/10/2018	AS BUILT DRAWING
01	15/10/2018	AS BUILT DRAWING
00	24/9/2018	AS BUILT DRAWING

PROJECT: CONSTRUCTION OF PHASE II WATER AND WASTEWATER NETWORKS AT ZAATARI REFUGEE CAMP



EMPLOYER: THE UNITED NATIONS CHILDREN'S FUND (UNICEF)

ENGINEER: GITEC CONSULT GMBH IN ASSOCIATION WITH CONSULTING ENGINEERING CENTER (CEC)

CONTRACTOR: MID CONTRACTING Co. AMMAN, JORDAN

DRAWING TITLE: PUMPING STATION IN DISTRICT 7 SOCKET

NO.	DATE	SCALE	DATE	BSET
2	N.T.S	22/10/2018	1/1	02

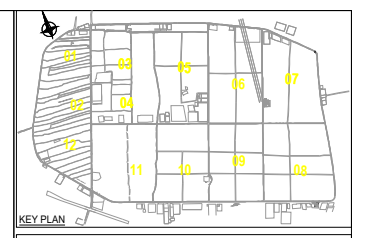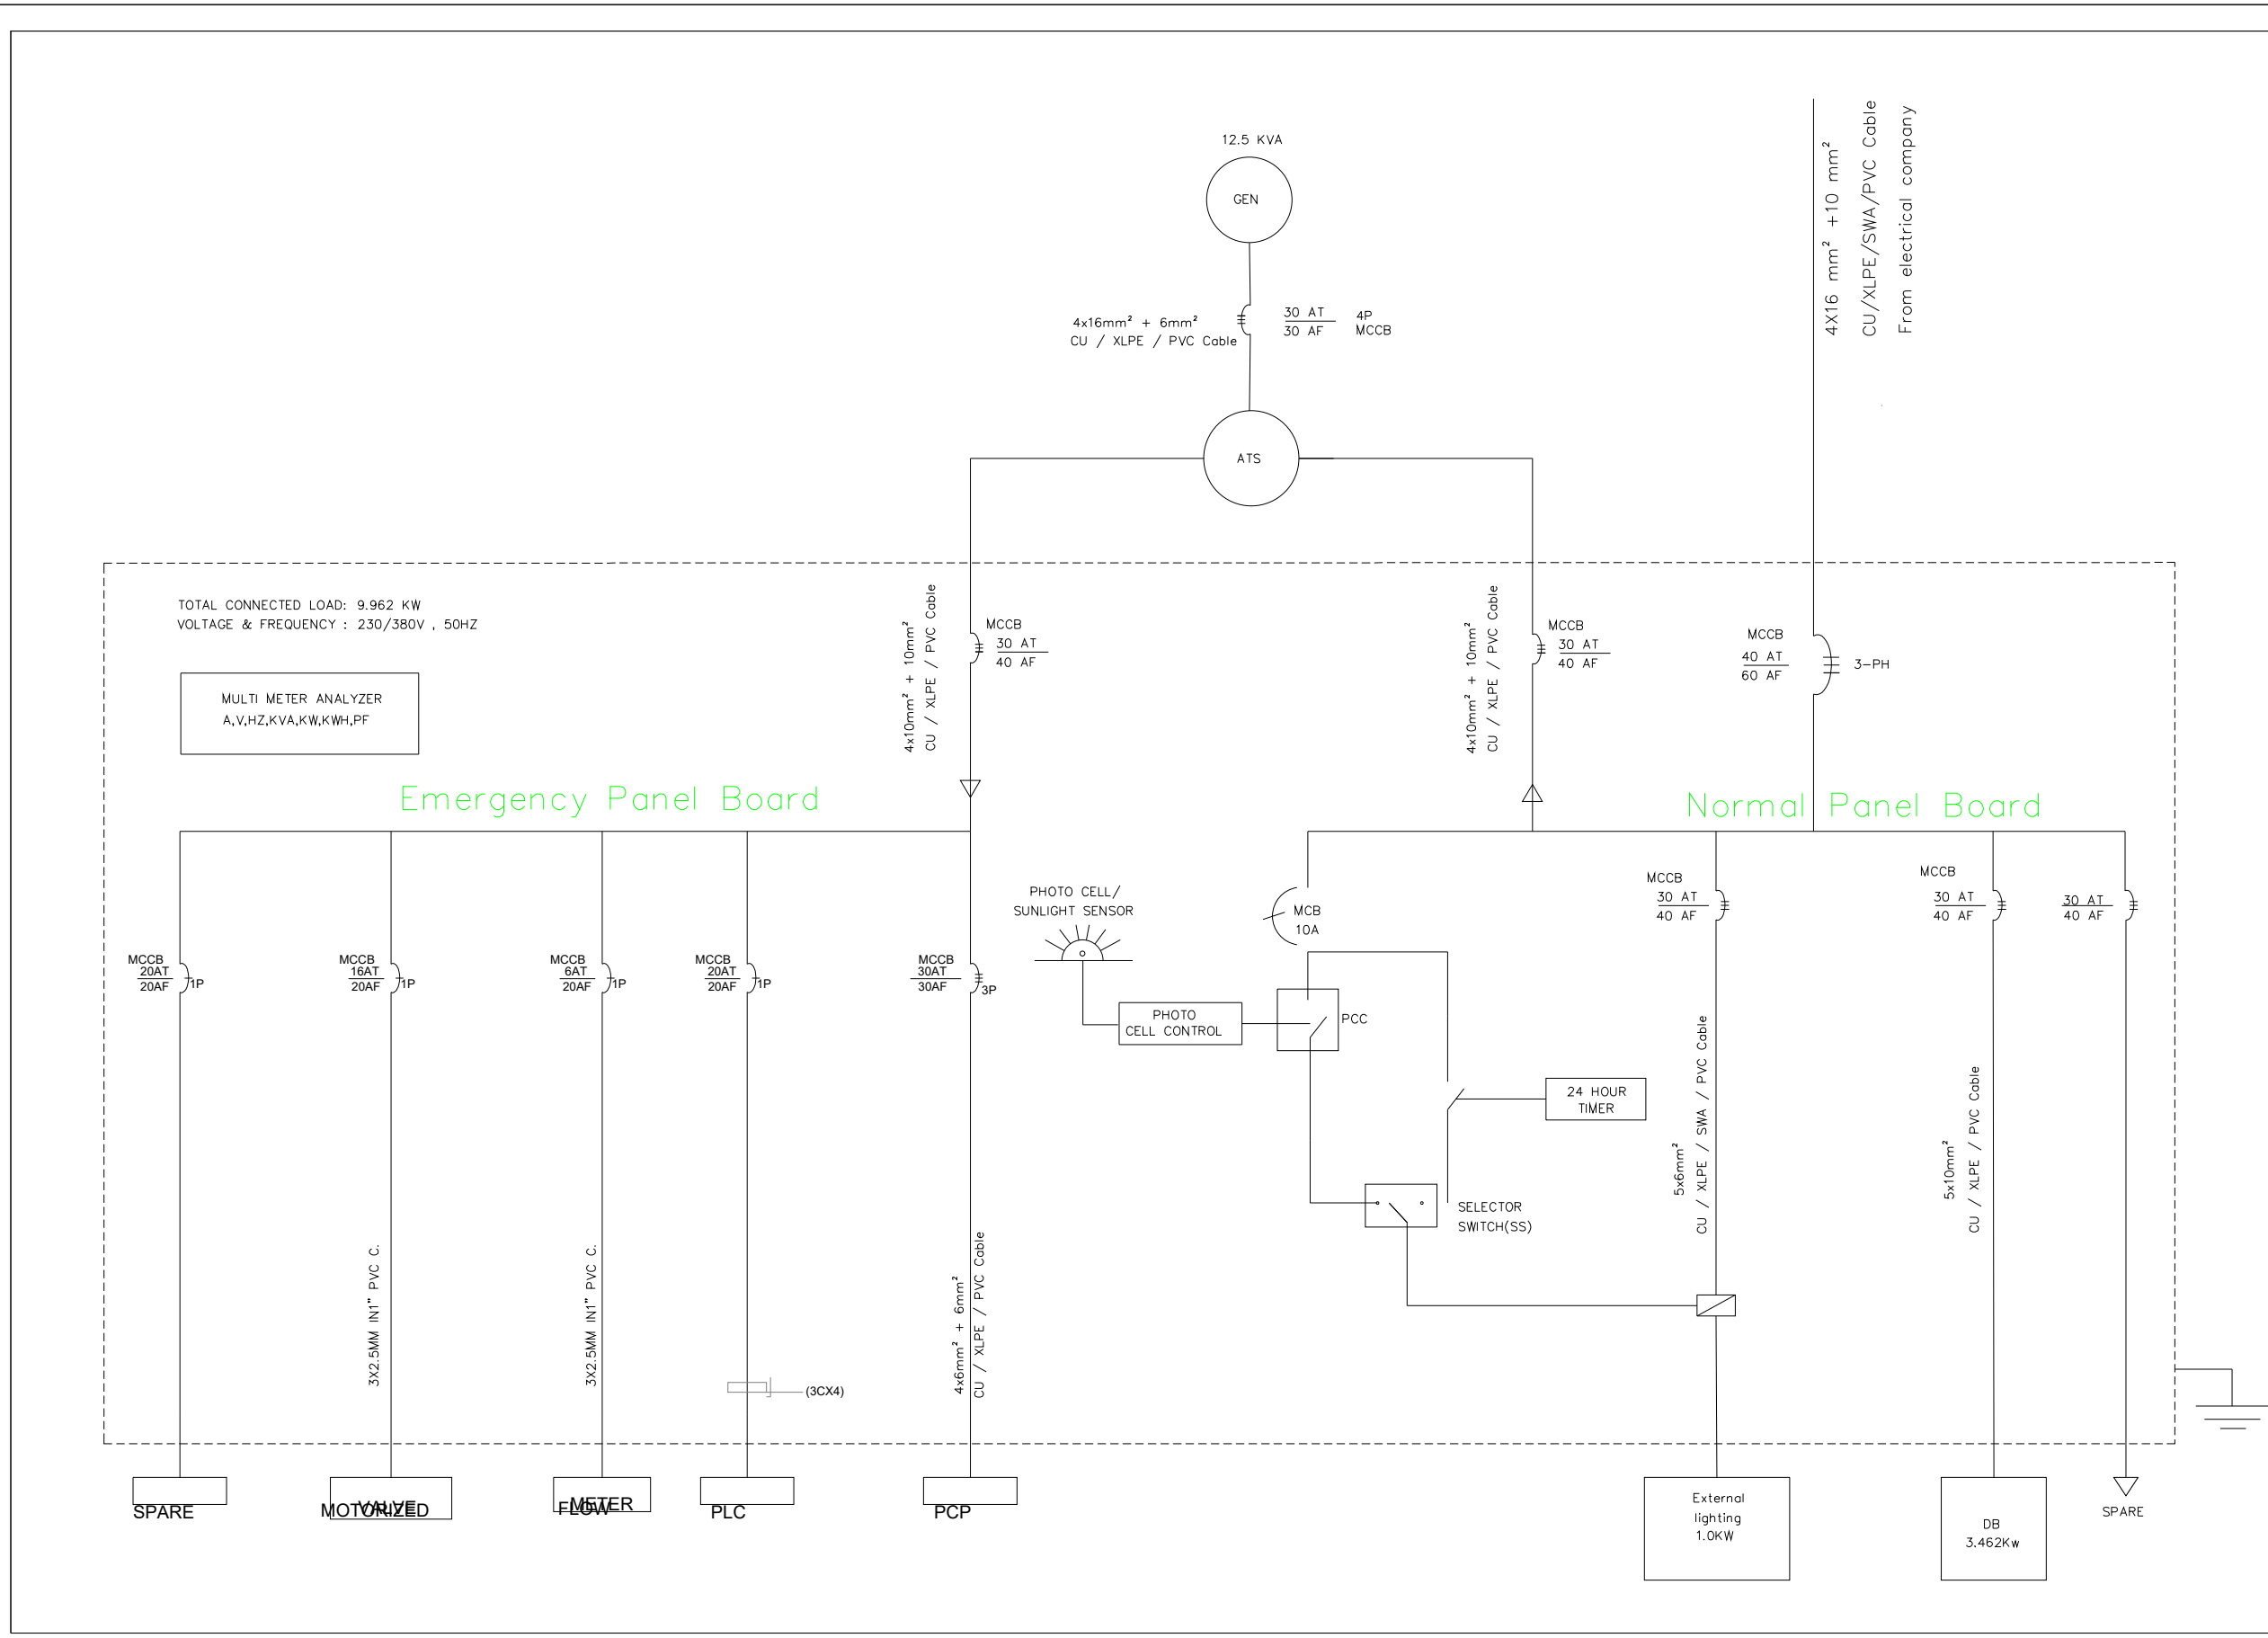

NOTE:

Package No.	Section No.	Section Title
1	1	Panel 1
1	2	Panel 2
1	3	Panel 3
1	4	Panel 4
1	5	Panel 5
1	6	Panel 6
1	7	Panel 7
1	8	Panel 8
1	9	Panel 9
1	10	Panel 10
1	11	Panel 11
1	12	Panel 12
1	13	Panel 13
1	14	Panel 14
1	15	Panel 15
1	16	Panel 16
1	17	Panel 17

LEGEND:

Symbol	Description
[Symbol]	Panel 1
[Symbol]	Panel 2
[Symbol]	Panel 3
[Symbol]	Panel 4
[Symbol]	Panel 5
[Symbol]	Panel 6
[Symbol]	Panel 7
[Symbol]	Panel 8
[Symbol]	Panel 9
[Symbol]	Panel 10
[Symbol]	Panel 11
[Symbol]	Panel 12
[Symbol]	Panel 13
[Symbol]	Panel 14
[Symbol]	Panel 15
[Symbol]	Panel 16
[Symbol]	Panel 17

REFERENCE DRAWINGS

Drawing No.	Drawing Title

REV	DATE	DESCRIPTION
02	22/10/2018	AS BUILT DRAWING
01	15/10/2018	AS BUILT DRAWING
00	24/9/2018	AS BUILT DRAWING

PROJECT: CONSTRUCTION OF PHASE II WATER AND WASTEWATER NETWORKS AT ZAATARI REFUGEE CAMP

EMPLOYER: THE UNITED NATIONS CHILDREN'S FUND (UNICEF)

ENGINEER: GITEC CONSULT GMBH IN ASSOCIATION WITH CONSULTING ENGINEERING CENTER (CEC)

CONTRACTOR: MID CONTRACTING Co. AMMAN, JORDAN

DRAWING TITLE: PUMPING STATION IN DISTRICT 7 MDB

DATE	BY	CHECKED BY	DATE	APPROVED BY	DATE

4-07-09-06

2 N.T.S 22/10/2018 1/1